

ALL WORK SHALL BE CARRIED OUT IN ACCORDANCE WITH ALL BY-LAWS AND CODES APPLICABLE TO THE LOCATION. ALL DIMENSIONS AND INFORMATION SHALL BE CHECKED ON SITE AND ANY VARIANCES REPORTED TO THE ARCHITECT PRIOR TO START OF WORK. THIS DRAWING IS NOT TO BE USED FOR CONSTRUCTION UNTIL SIGNED BY THE ARCHITECT. THIS DRAWING AND THE DESIGN HEREIN ARE THE COPYRIGHT OF THE ARCHITECT AND MAY NOT BE REPRODUCED, ALTERED OR REUSED WITHOUT WRITTEN CONSENT. THIS DRAWING MUST NOT BE SCALED.

ISSUE	NO.	REVISIONS	DATE
AS BUILT	5		06/11/08
REV.1	4		01/08/03
CONSTRUCTION / BP.4	3		15/05/03

**WILLIAM R. DEWSON  
ARCHITECT**  
135 ALGORN AVENUE,  
TORONTO, ONTARIO  
M4V 1E5  
416 996 6635


**BLACKWELL ENGINEERING  
LIMITED**  
SUITE 405, 19 DUNCAN ST.,  
TORONTO, ONTARIO  
M5H 3H1  
416 593 5300

**ALLEN COTTAGE**  
ISLAND NO. 347  
GEORGIAN BAY, ONTARIO  
PROJECT NO: 0110

**ELEVATIONS  
SOUTH FACE**

DRAWN BY: Jc / ds  
CHECKED BY: WRD  
1/8" = 1'-0"

**A6**

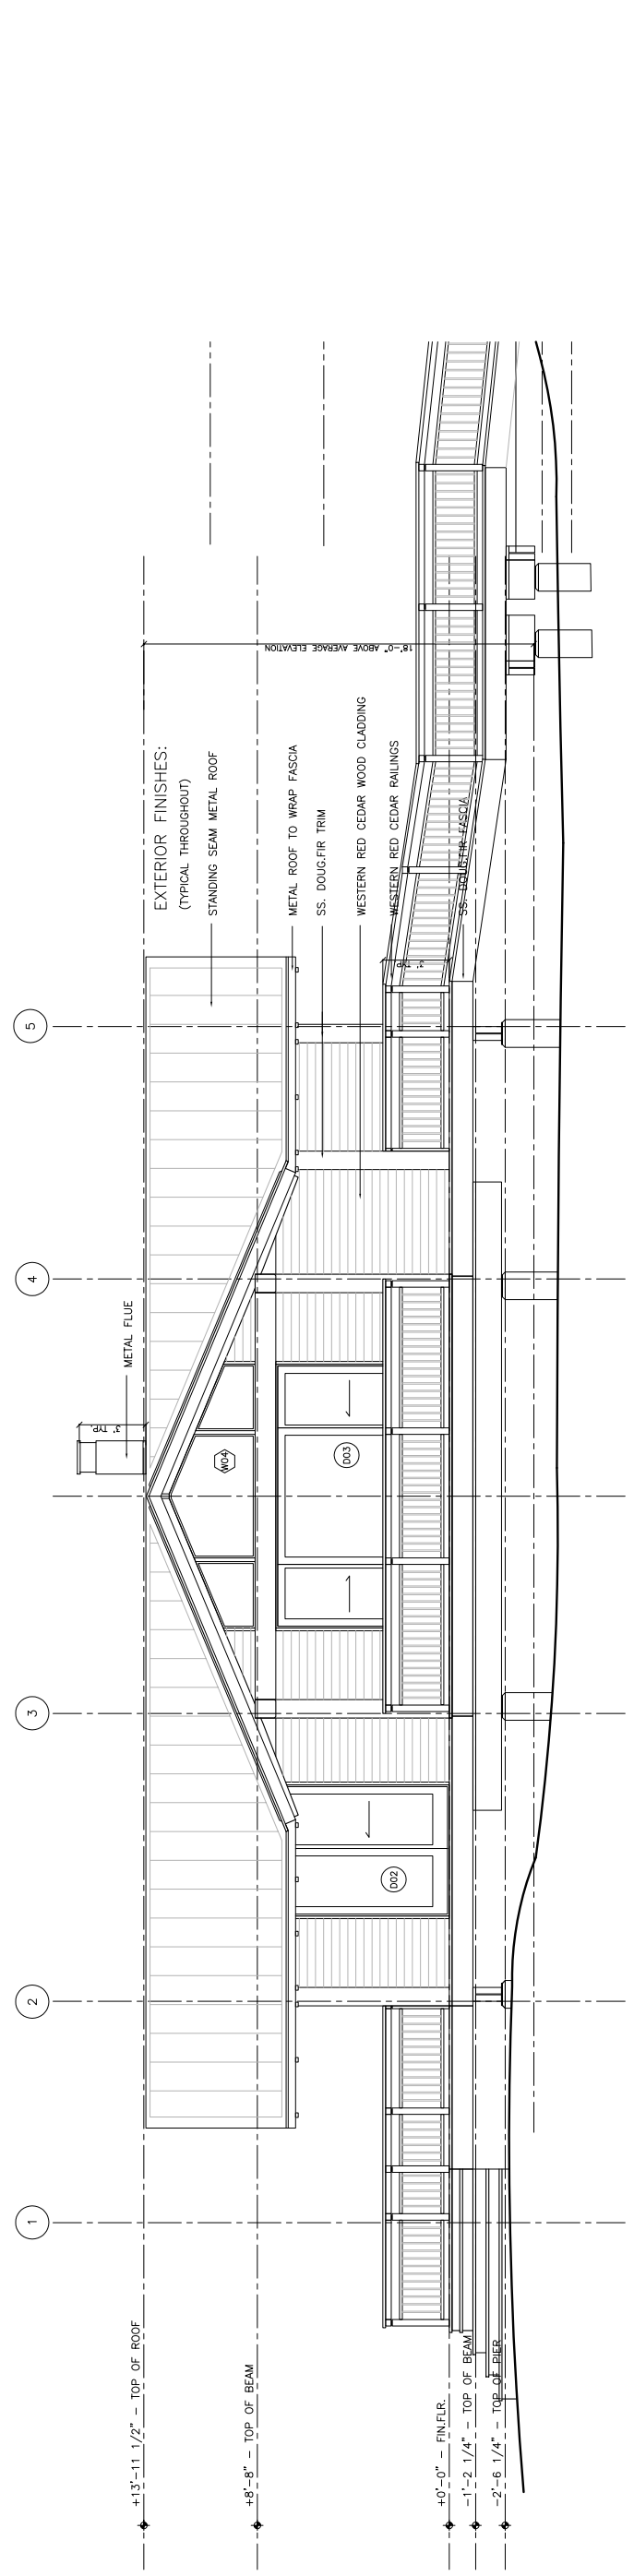


**MAIN COTTAGE**

8

7

6

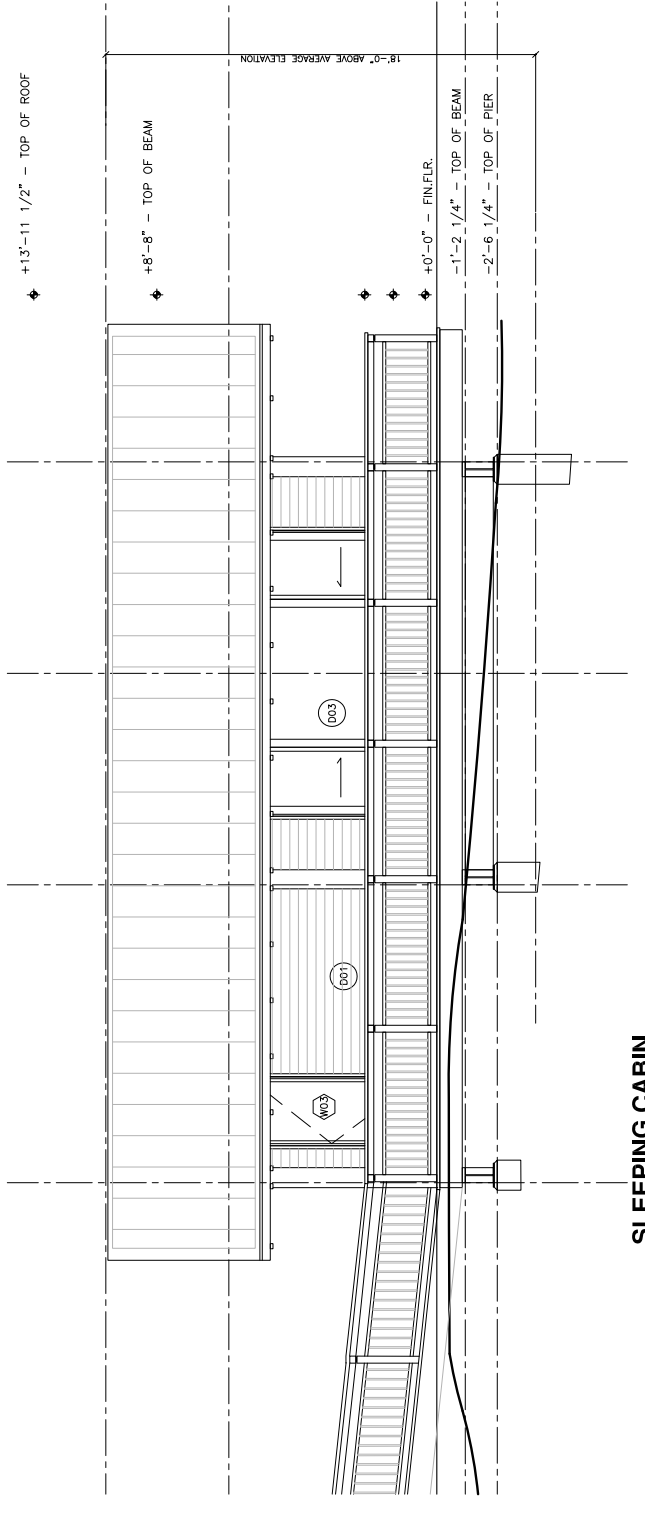

**SLEEPING CABIN**